


DATE	
BY	
DESIGNED	
CHECKED	
PLOTTED	
SUBMITTED	
NO	
NOTE BOOK	
PLAN	

DATE	
BY	
DESIGNED	
CHECKED	
PLOTTED	
SUBMITTED	
NO	
NOTE BOOK	
PROFILE	

9005-07  
 Sheet 5 of 13  
 Facility: D

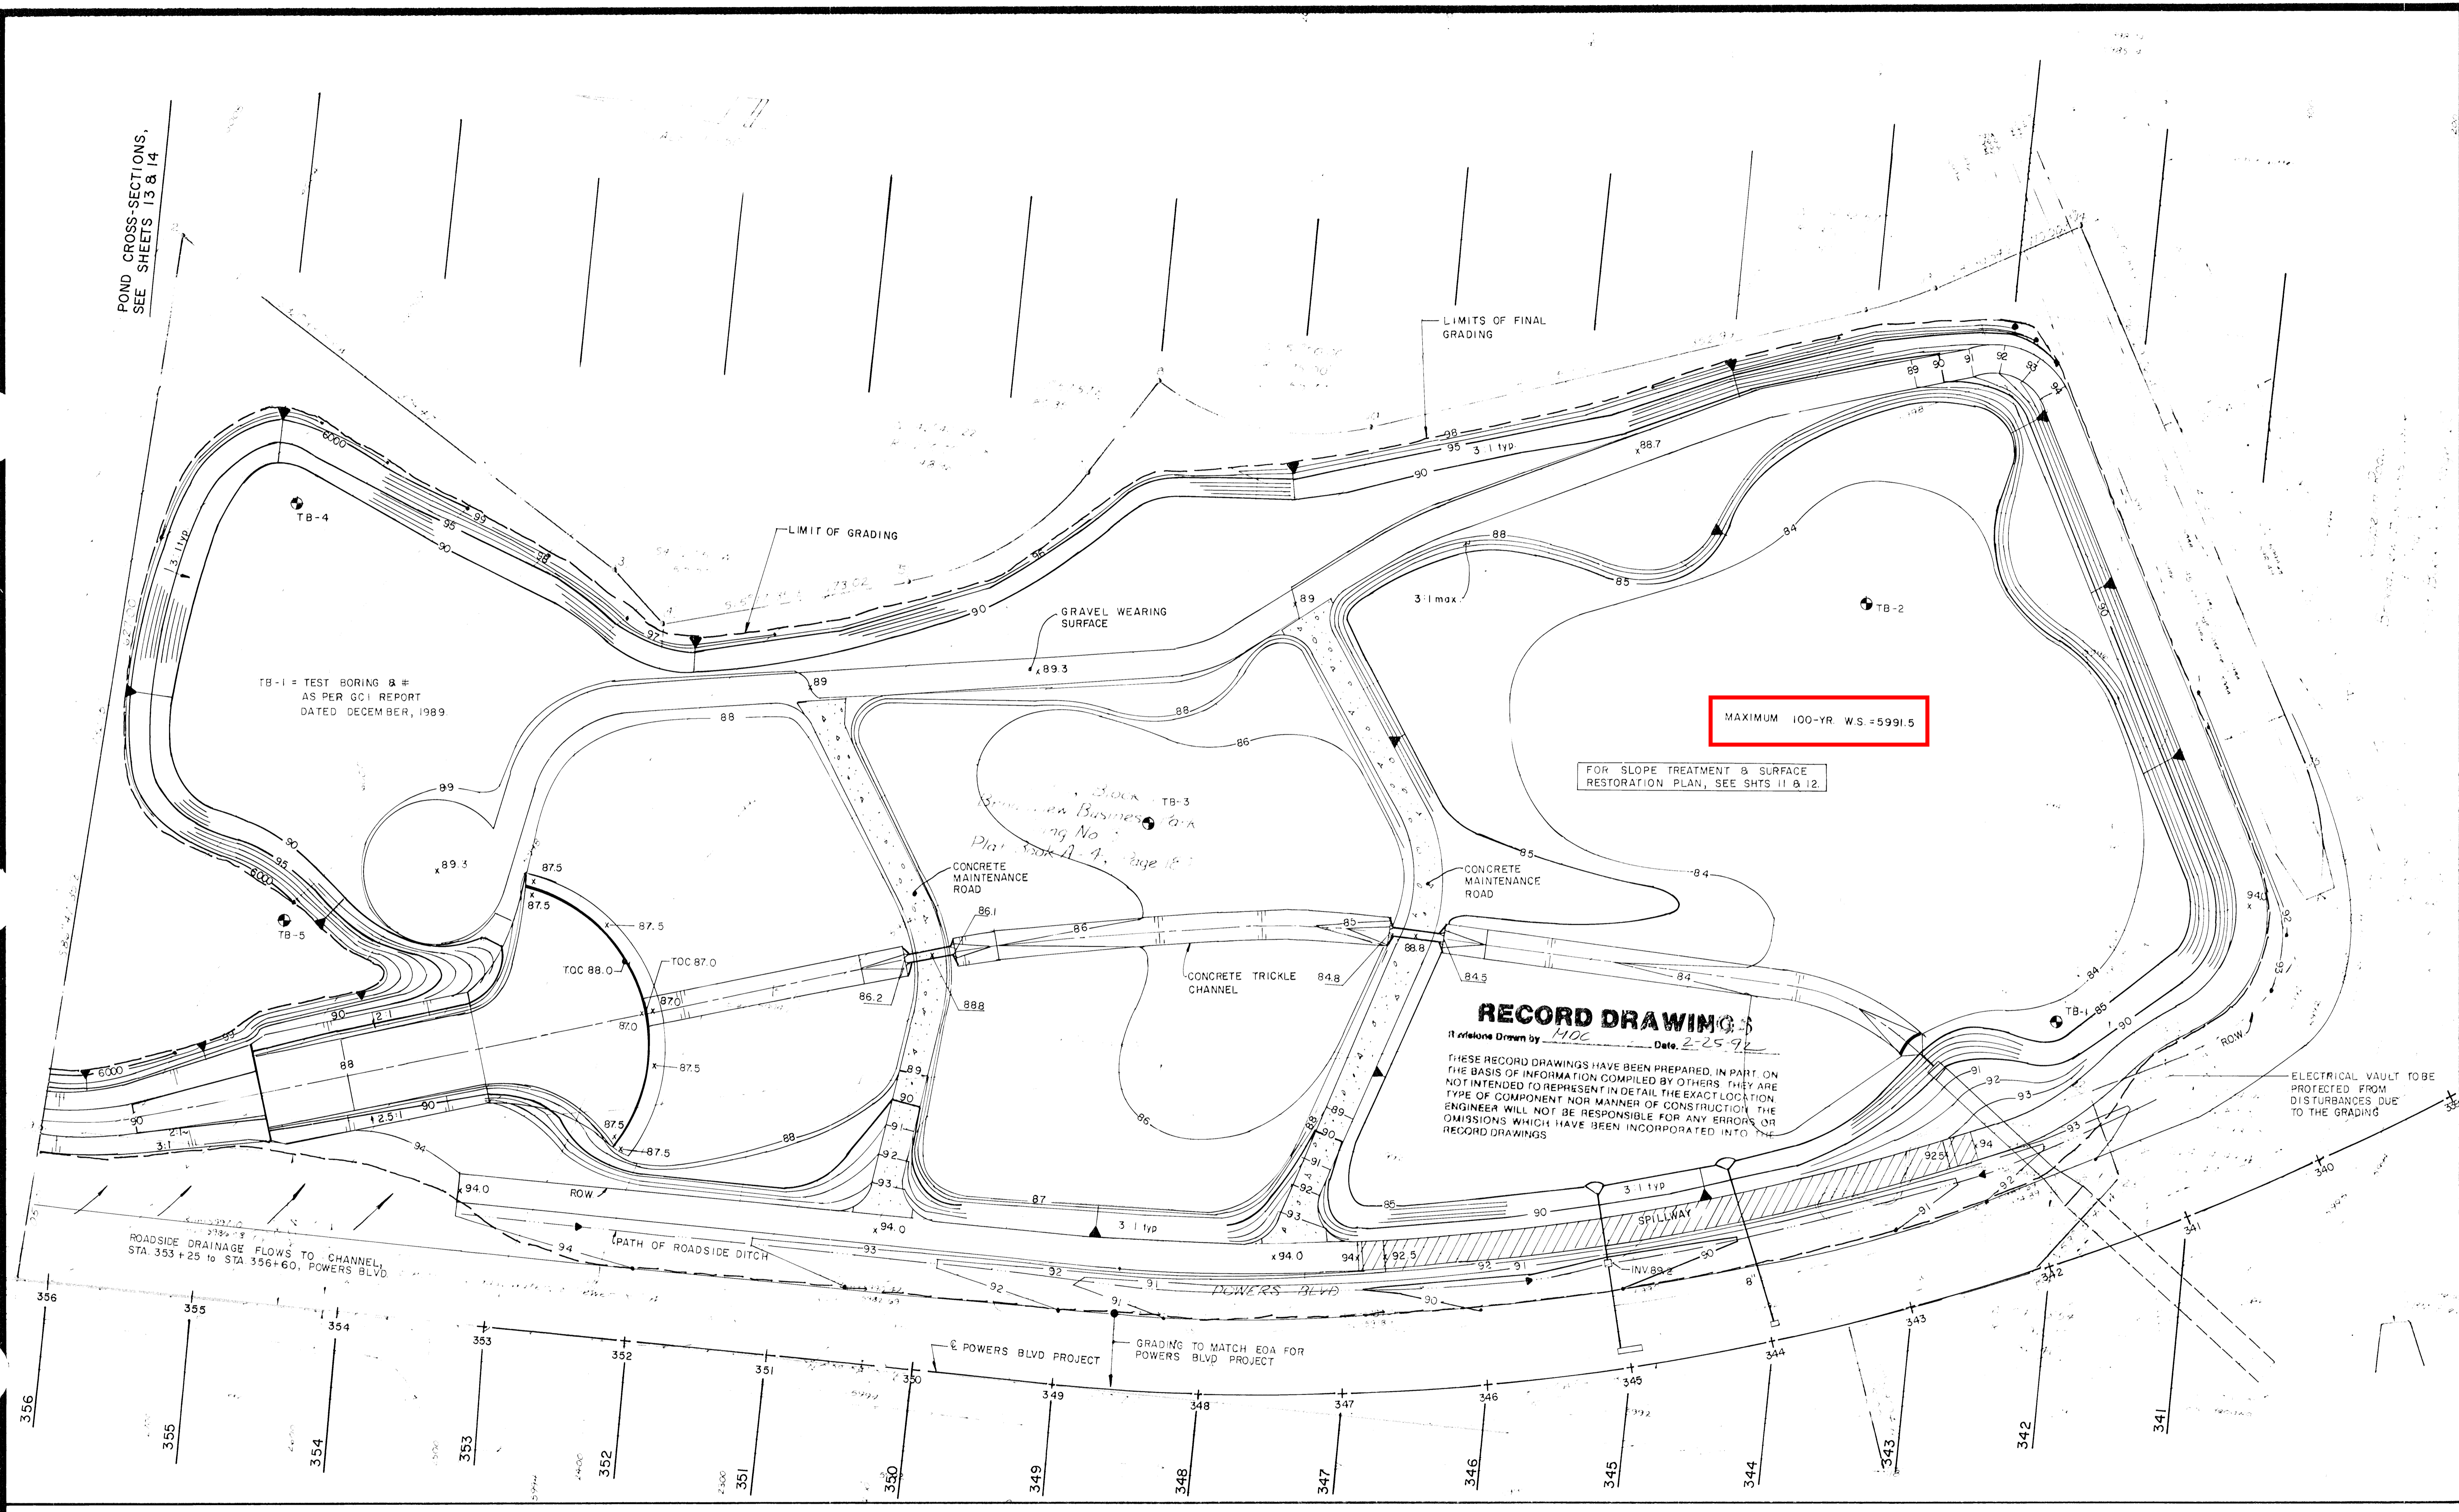

**RECORD DRAWING**  
 It is hereby certified that these drawings were prepared by the undersigned on the basis of information compiled by others. They are not intended to represent in detail the exact location, type of component nor manner of construction. The engineer will not be responsible for any errors or omissions which have been incorporated into the record drawings.  
 Drawn by: *MOC* Date: *2-25-97*

<p><b>STATEMENT:</b>          THE CITY OF COLORADO SPRINGS RECOGNIZES THE DESIGN ENGINEER AS HAVING RESPONSIBILITY FOR THE DESIGN; THE CITY HAS LIMITED ITS SCOPE OF REVIEW ACCORDINGLY. RESUBMITTAL REQUIRED IF CONSTRUCTION HAS NOT COMMENCED WITHIN 180 DAYS AFTER REVIEW DATE.</p>	<p><b>REVIEW:</b>          DESIGN: _____ DATE _____          ROUGH CUT REVIEW _____ DATE _____          FINAL REVIEW _____ DATE _____          DRAINAGE DESIGN: FILED IN ACCORDANCE WITH SECTION 15-3-906 OF THE CODE OF COLORADO SPRINGS 1980, AS AMENDED _____ DATE _____</p>	<p><b>DESIGN DATA:</b>          SIDEWALKS: WIDTH _____          LOCATION: Attached <input type="checkbox"/> Detached, 6" from P/L <input type="checkbox"/>          CURB TYPE 1 <input type="checkbox"/> 2 <input type="checkbox"/> 3 <input type="checkbox"/>          R/W WIDTH _____ F/C - F/C _____          STREET TYPE _____ HVEEM _____</p>	<p><b>ASPHALT THICKNESS:</b>          AC Surface _____          AC Base _____  <b>AGG. BASE THICKNESS:</b>          Class 6 _____          Class 5 _____          Class 2 _____</p>	<p><b>SCALE:</b> HORIZ. _____ VERT. _____  <b>BENCHMARK:</b> BRASS CAP LOCATED AT THE S.W. COR. OF THE BRIDGE, 2000' ± WEST OF POWERS BLVD. ON US 24 BRIDGE OVER SAND CREEK EL. 6190.00 USGS</p>	<p><b>REVISIONS:</b></p> <table border="1"> <thead> <tr><th>NO.</th><th>DESCRIPTION</th><th>DATE</th></tr> </thead> <tbody> <tr><td> </td><td> </td><td> </td></tr> <tr><td> </td><td> </td><td> </td></tr> <tr><td> </td><td> </td><td> </td></tr> </tbody> </table>	NO.	DESCRIPTION	DATE										<p><b>ENGINEER:</b>          Kiowa Engineering Corporation          419 W. BIJOU STREET          COLORADO SPRINGS          COLORADO 80905          DESIGNED BY: JYC DATE: 4/90          DRAWN BY: EAK DATE: 5/90          CHECKED BY: RNW DATE: 5/90</p> <p><b>PROJECT:</b> POWERS BOULEVARD DETENTION POND          GRADING PLAN          SUBDIVISION: _____          DRAINAGE BASIN: PETERSON FIELD          JOB NO.: 89-08-16 SHEET 05 OF 15</p>
NO.	DESCRIPTION	DATE																

9005-07-5