


H = FEET OFFSET TO
 P = INCH PAVEMENT
 W = FEET
 HVEEM VALVE _____
 TRAFFIC INDEX _____
 DATE TESTED _____

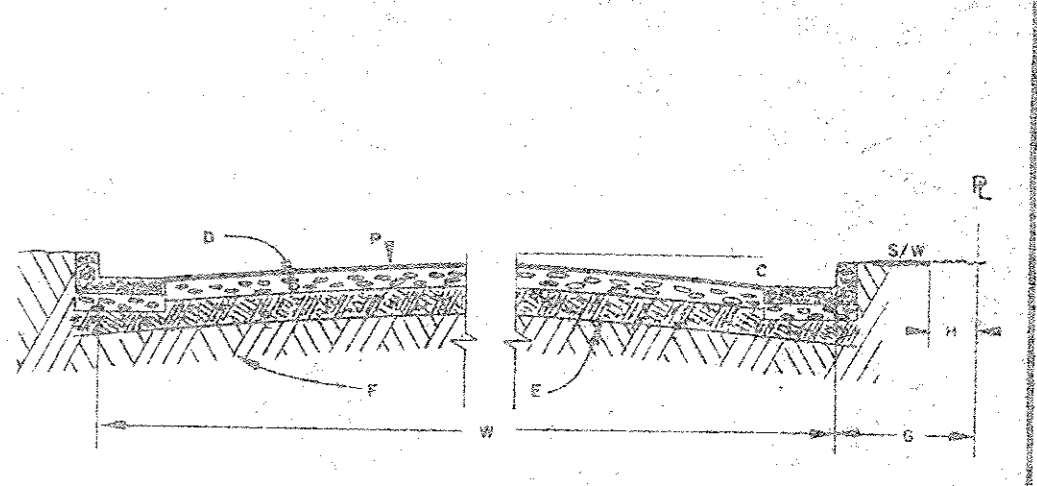

ENGINEERING DEPARTMENT
 CURB AND GUTTER — GRADES
 APPROVED _____
 DATE _____
 SIGNED _____
 GRADES REVIEWED: _____
 DATE _____
 SIGNED _____

JOB NO. _____

DEERFIELD HILLS DRAINAGE SYSTEM
 Existing Structures By The Department of Highways

SCALE: Vert: 1" = 6'
 Horiz: 1" = 40'

APPROVED BY: *[Signature]*
 Allan D. Miller P.E. 5076

PLAN BY: Asbuilt - By The
 DIVISION OF HIGHWAYS
 DRAWN BY: S.L. Grant 4/1/72

SURVEYED BY: _____ CHECKED BY: _____

UNITED WESTERN ENGINEERS
 4525 Northpark Drive
 Colorado Springs, Colorado

SHEET _____ OF _____

FILES REPRODUCTIONS